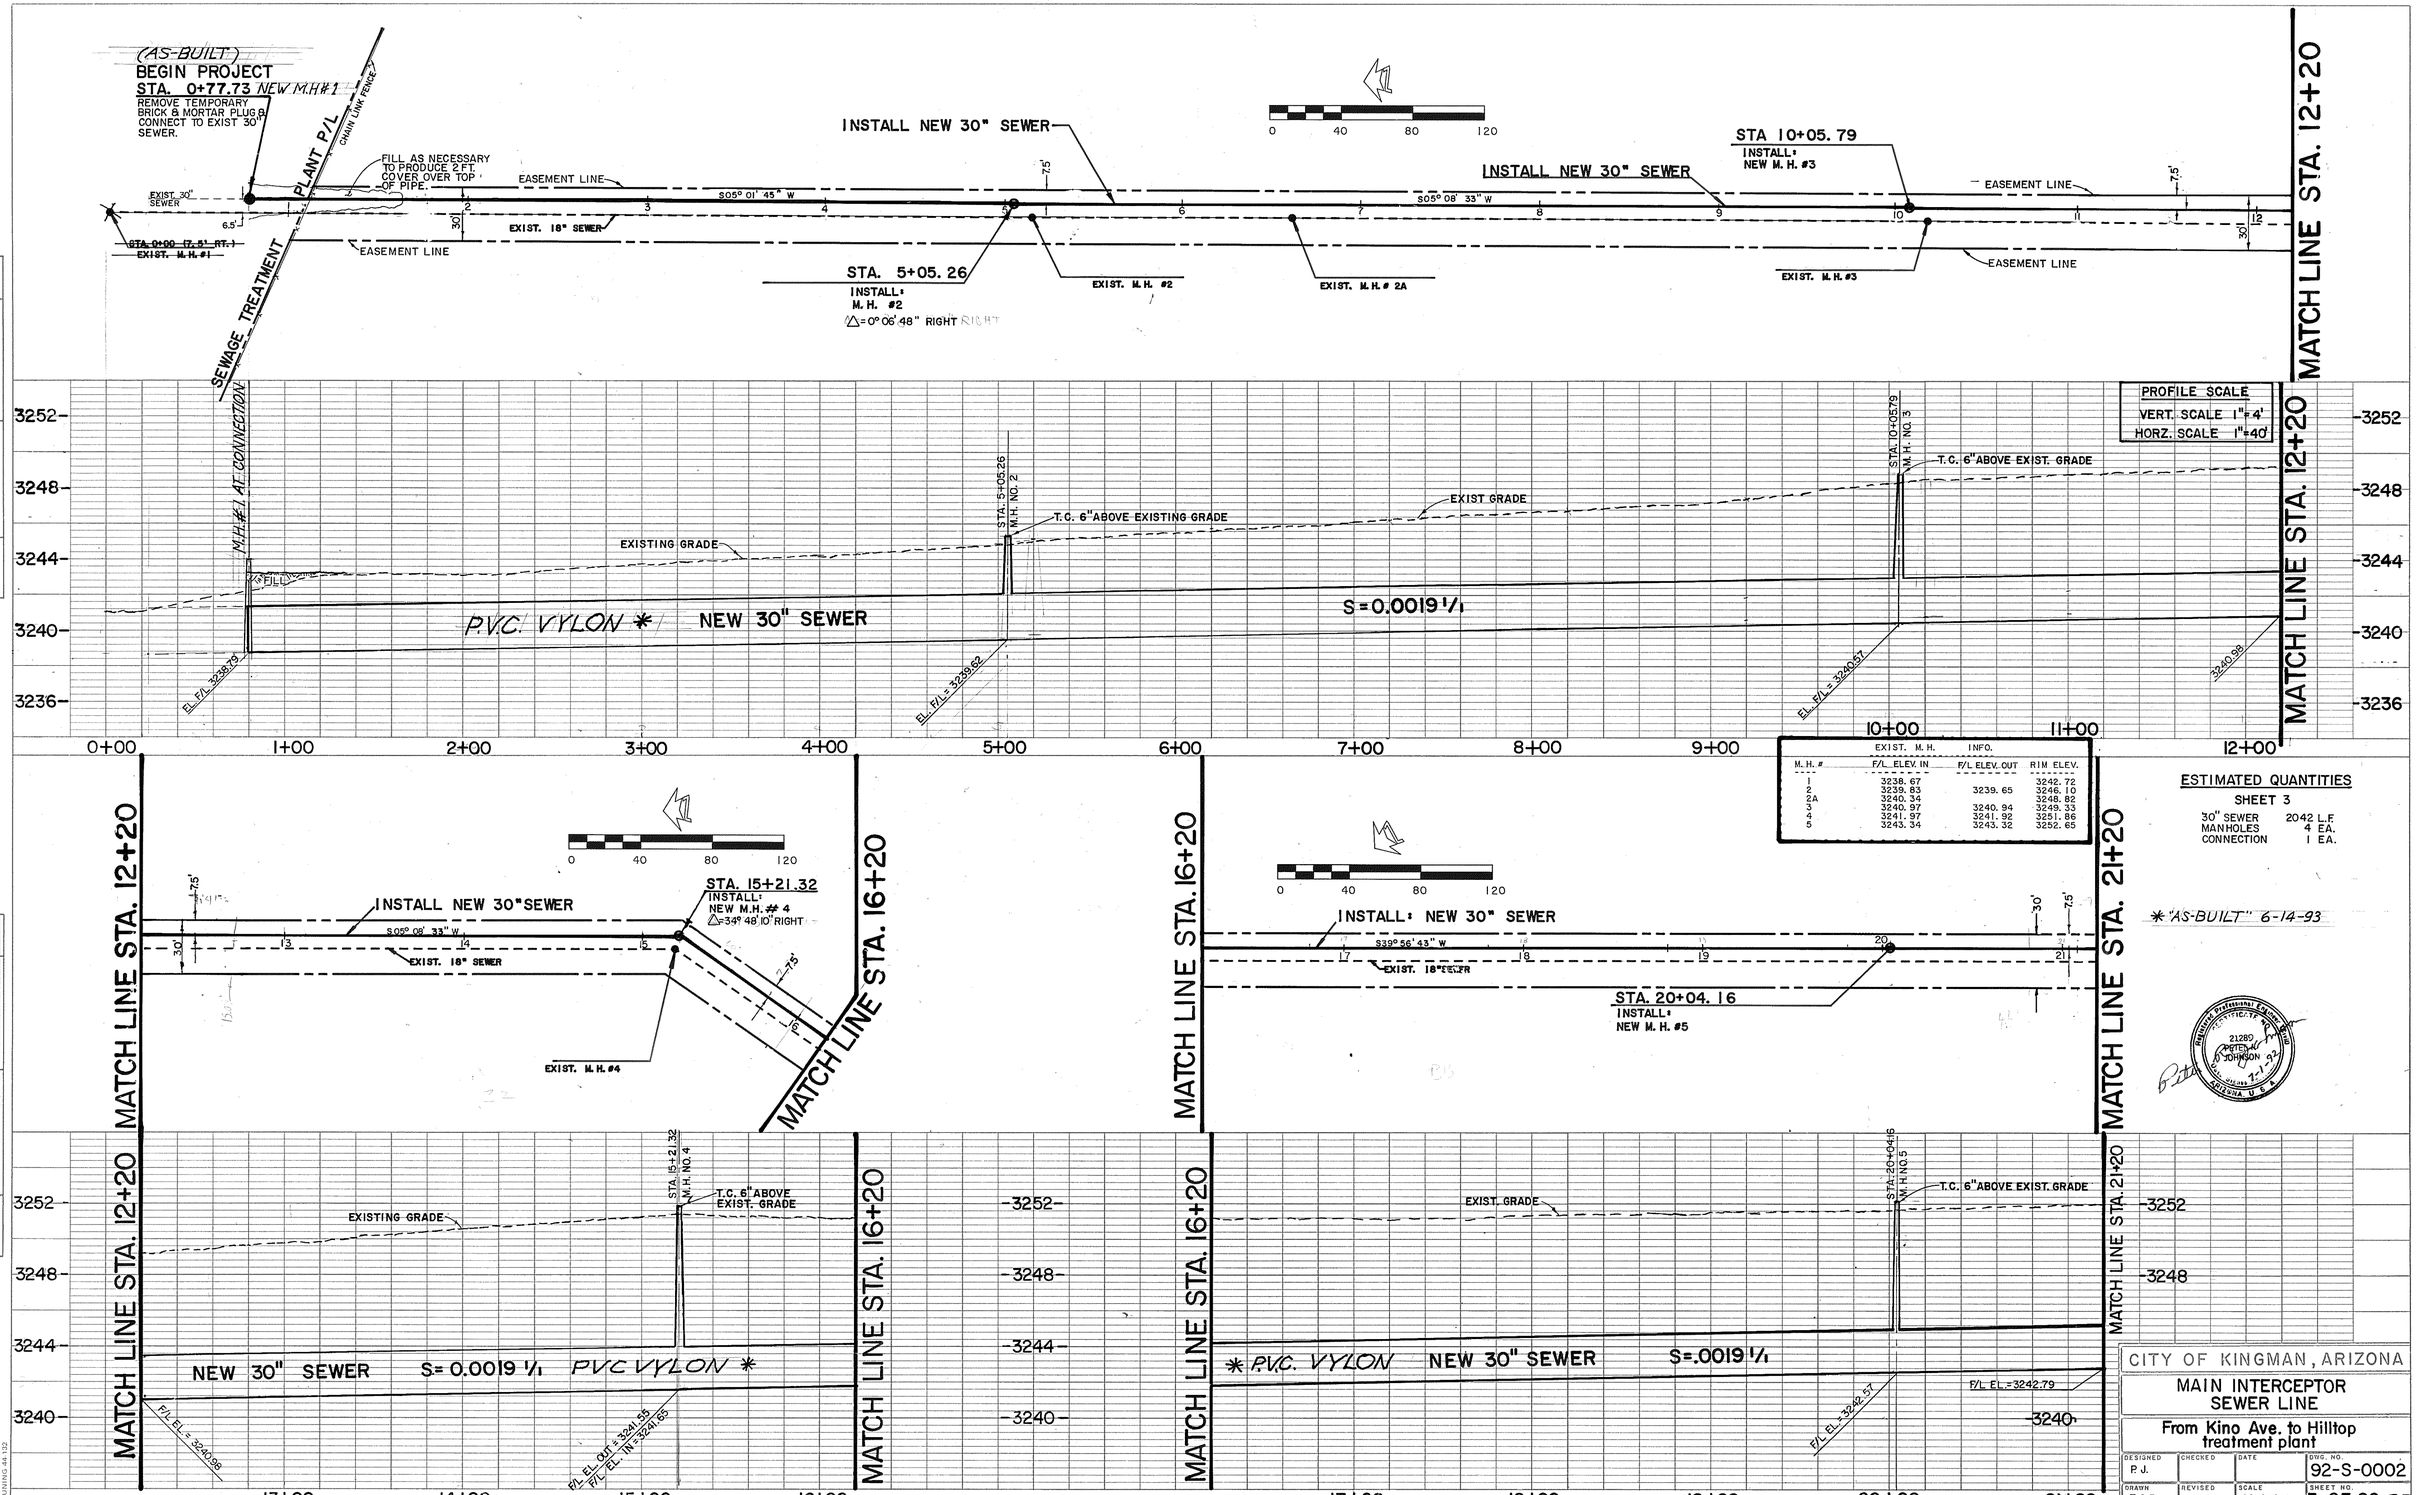

EXIST. M.H. INFO.			
M.H. #	F/L ELEV. IN	F/L ELEV. OUT	RIM ELEV.
1	3238.67		3242.72
2	3239.83	3239.65	3246.10
2A	3240.34		3248.82
3	3240.97	3240.94	3249.33
4	3241.97	3241.92	3251.86
5	3243.34	3243.32	3252.65

ESTIMATED QUANTITIES

SHEET 3

30" SEWER	2042 L.F.
MANHOLES	4 EA.
CONNECTION	1 EA.

* "AS-BUILT" 6-14-93

PLAN — SURVEYED / PLOTTED / ALIGNMENT CHECKED / RT. OF WAY CHECKED — NOTE BOOK NO. — BY — DATE

PROFILE — SURVEYED / PLOTTED / GRADES CHECKED / B.M. NOTED / STRUCTURE NOTAT'NS CH'KD — NOTE BOOK NO. — BY — DATE

CITY OF KINGMAN, ARIZONA

MAIN INTERCEPTOR SEWER LINE

From Kino Ave. to Hilltop treatment plant

DESIGNED	CHECKED	DATE	DWG. NO.
P.J.			92-S-0002
DRAWN	REVISED	SCALE	SHEET NO.
T.G.P.		AS-SHOWN	3 OF ~~20~~ 23 *

BRUNING 44-132

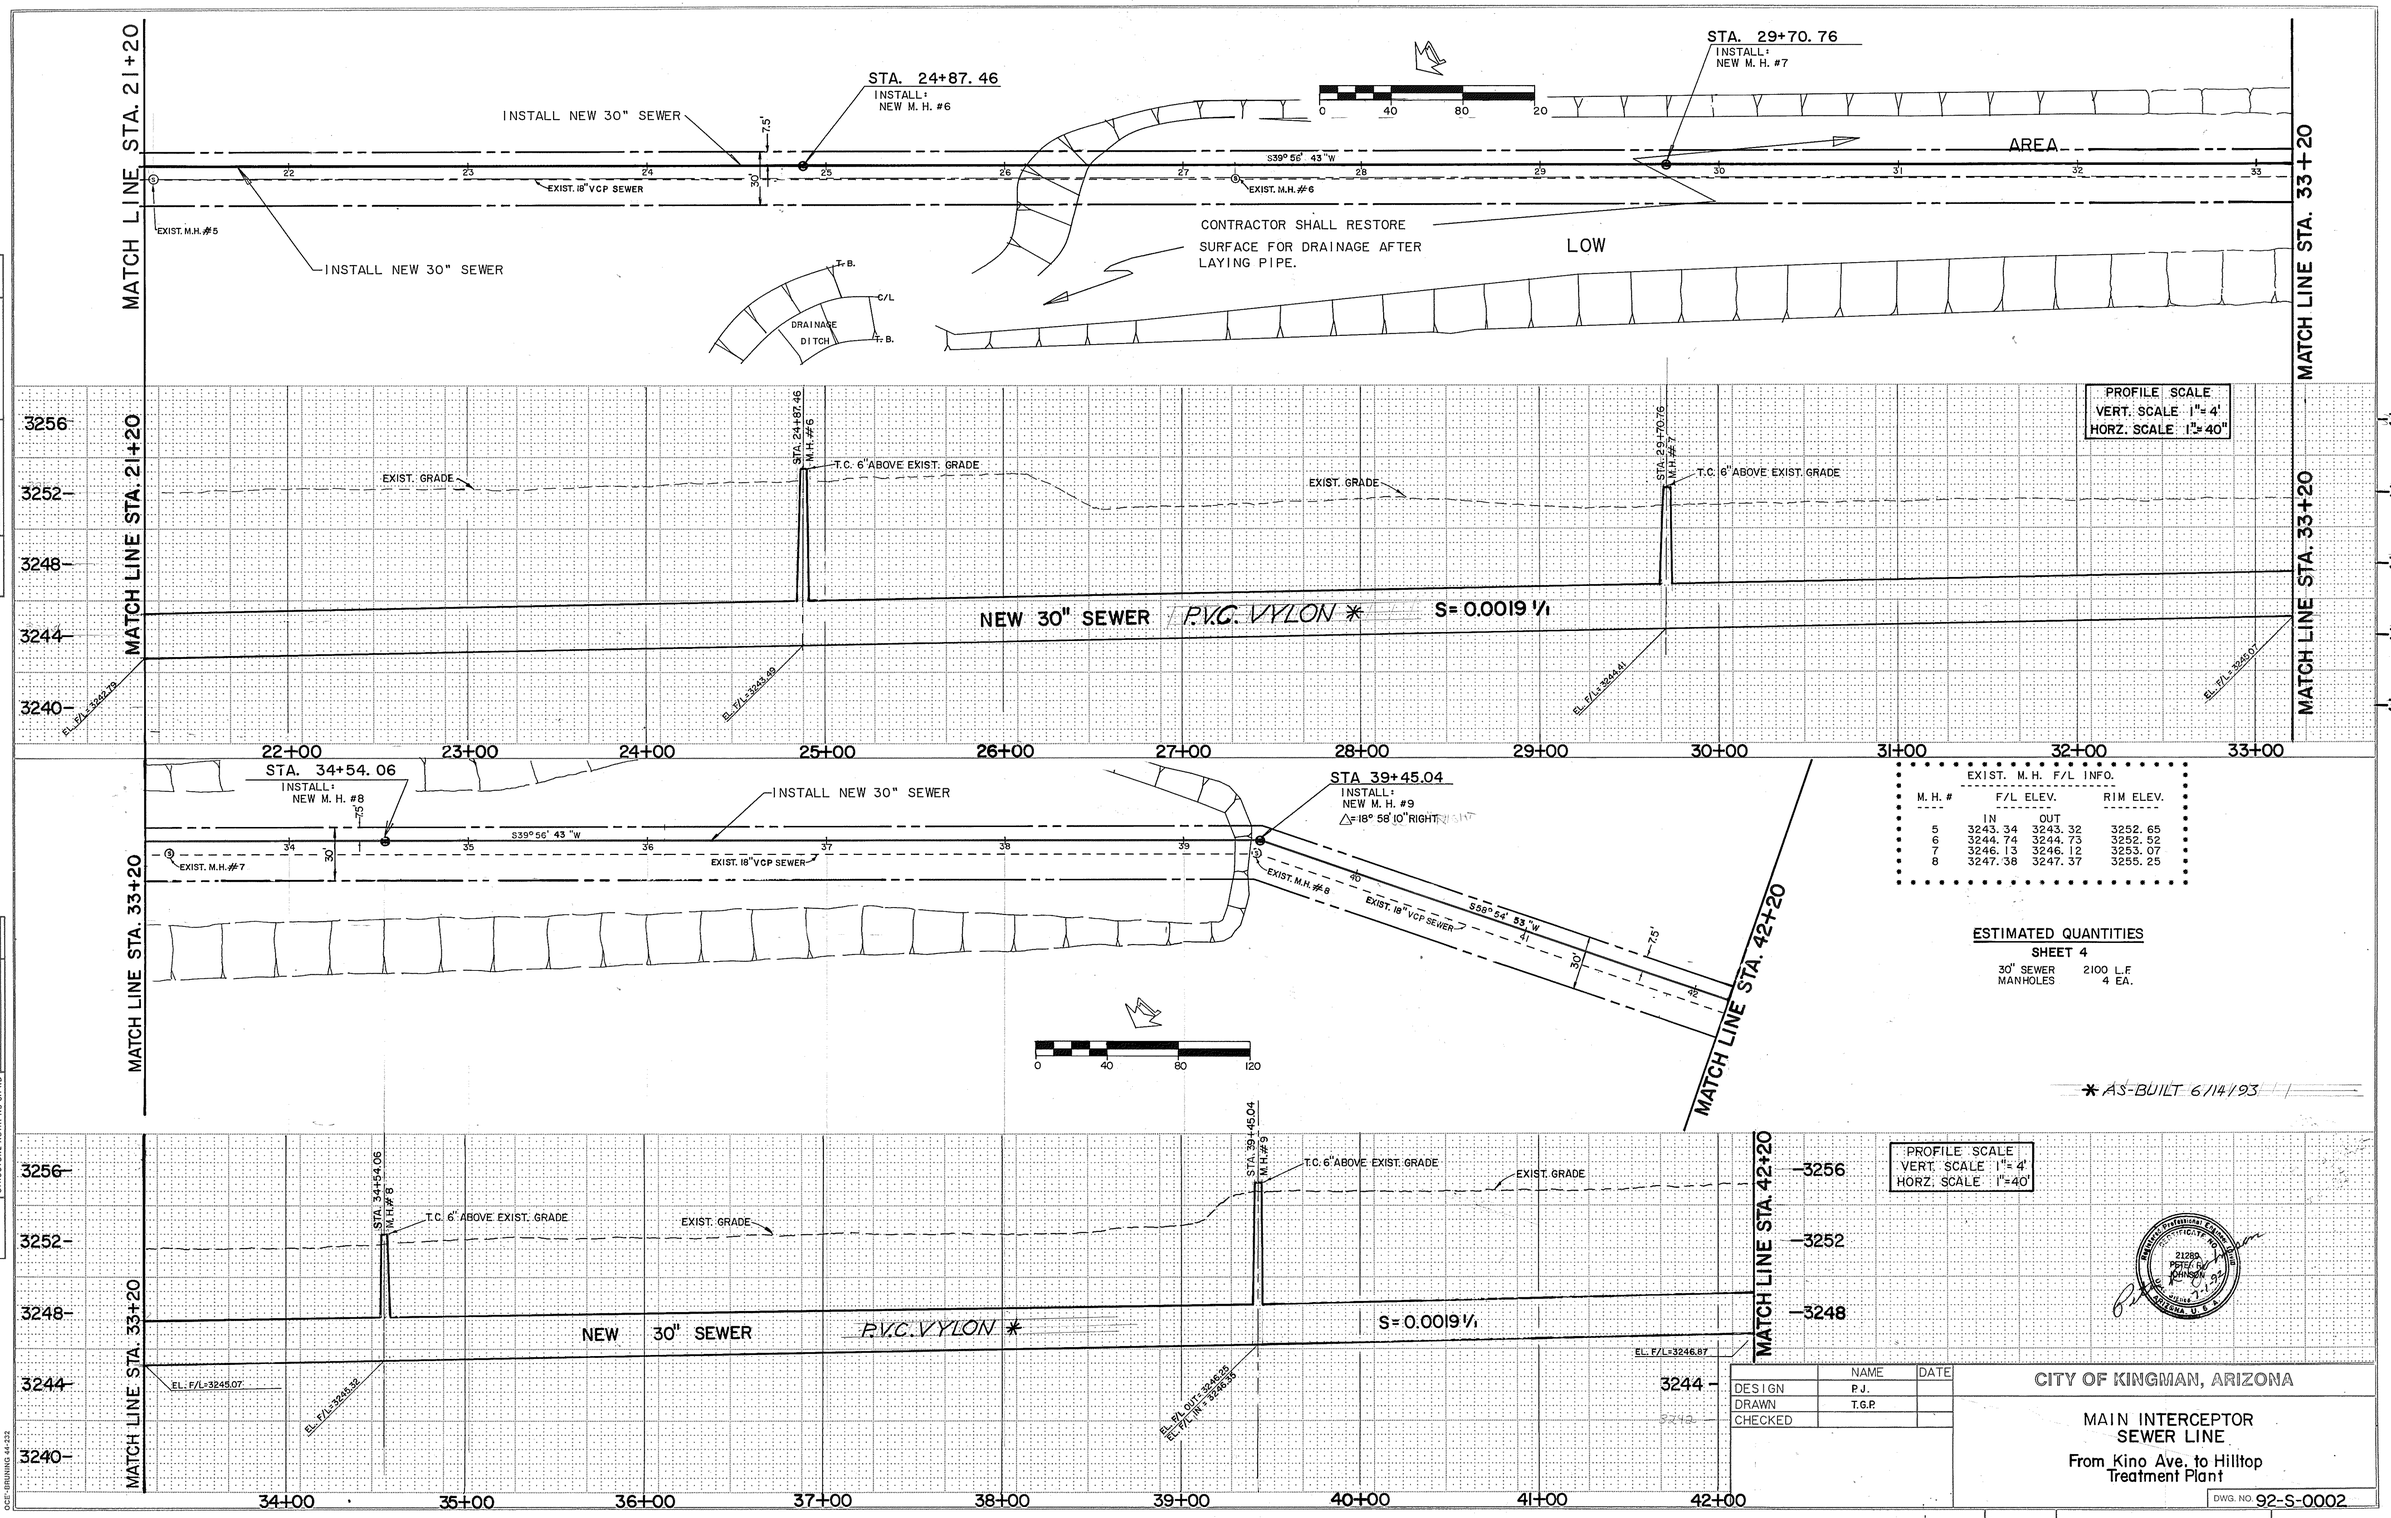

	NAME	DATE
DESIGN	P.J.	
DRAWN	T.G.P.	
CHECKED		

CITY OF KINGMAN, ARIZONA

MAIN INTERCEPTOR SEWER LINE

From Kino Ave. to Hilltop Treatment Plant

DWG. NO. 92-S-0002

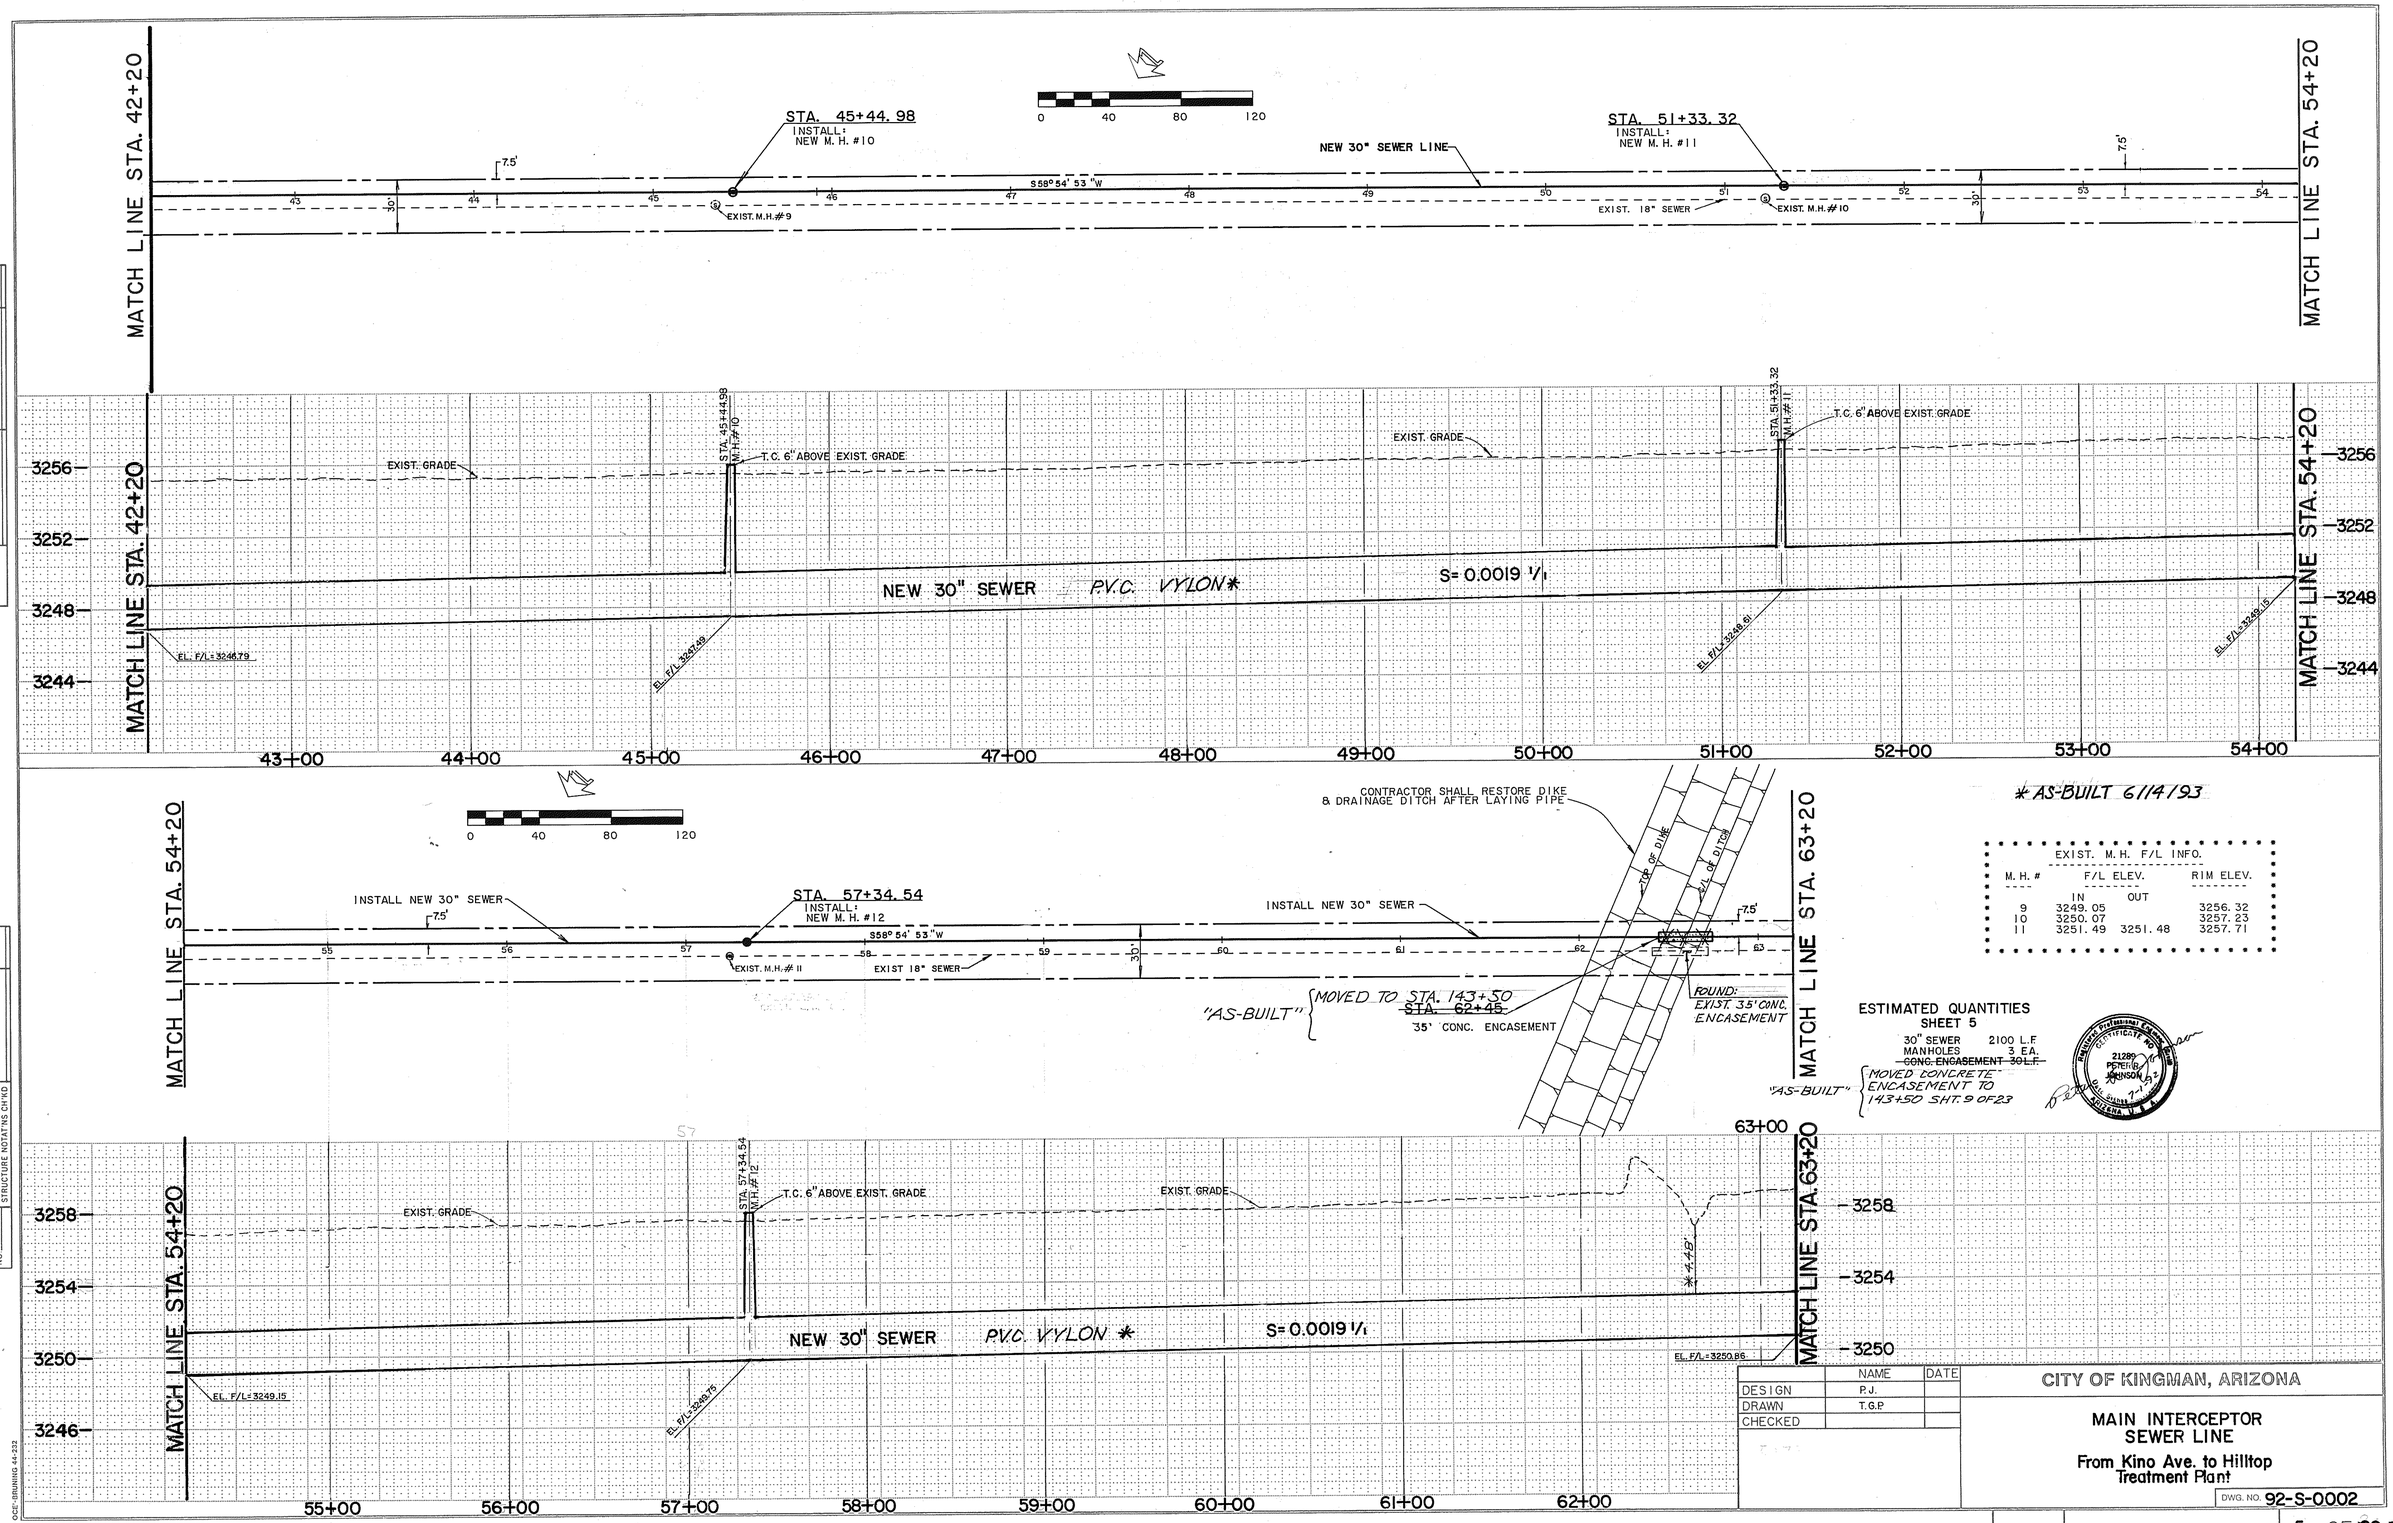

*AS-BUILT 6/14/93

EXIST. M.H. F/L INFO.

M.H. #	F/L ELEV. IN	F/L ELEV. OUT	RIM ELEV.
9	3249.05		3256.32
10	3250.07		3257.23
11	3251.49	3251.48	3257.71

ESTIMATED QUANTITIES
SHEET 5

30" SEWER 2100 L.F.
MANHOLES 3 EA.
~~CONC. ENCASEMENT 30 L.F.~~

"AS-BUILT" MOVED CONCRETE ENCASEMENT TO 143+50 SHT. 9 OF 23

Registered Professional Engineer (Civil) CERTIFICATE NO. 21289 PETER R. JOHNSON Date Signed 7-1-92 ARIZONA, U.S.A.

	NAME	DATE
DESIGN	P.J.	
DRAWN	T.G.P.	
CHECKED		

CITY OF KINGMAN, ARIZONA

MAIN INTERCEPTOR SEWER LINE

From Kino Ave. to Hilltop Treatment Plant

DWG. NO. 92-S-0002

5 OF ~~20~~ 23*

PLAN — NOTE BOOK NO. — SURVEYED — PLOTTED — ALIGNMENT CHECKED — RT. OF WAY CHECKED — BY — DATE

PROFILE — NOTE BOOK NO. — SURVEYED — PLOTTED — GRADES CHECKED — B.M. NOTED — STRUCTURE NOTAT'NS CH'KD — BY — DATE

OCE-BRUNING 44-232